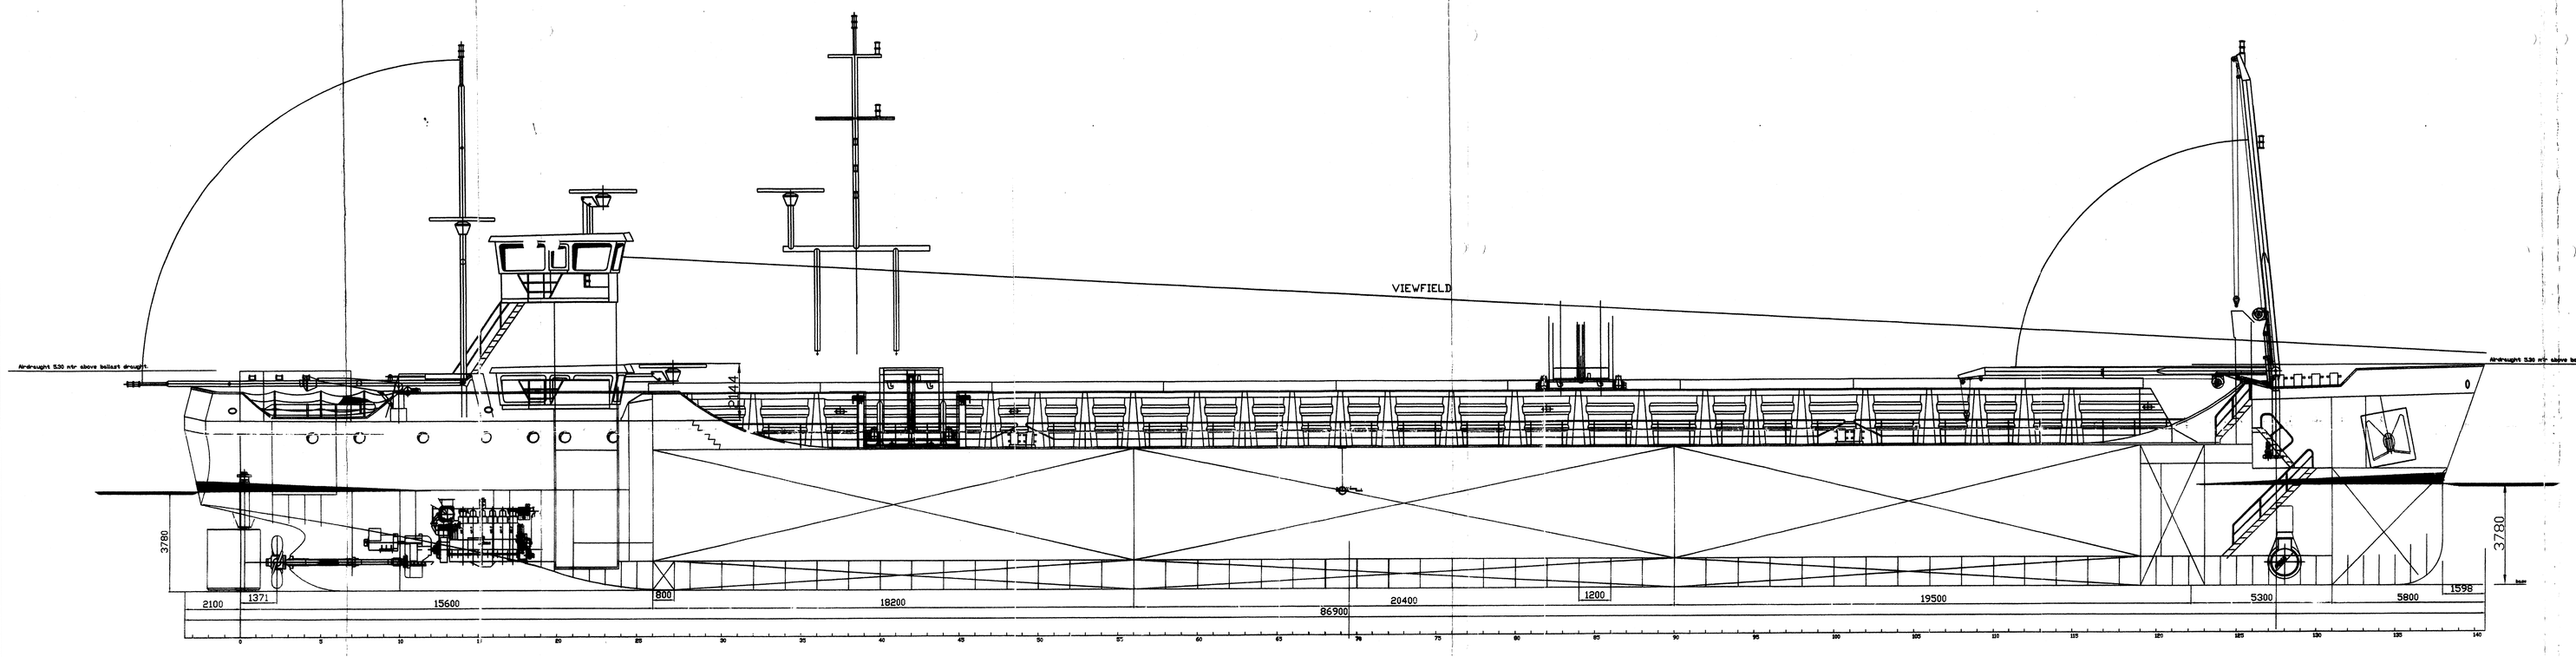

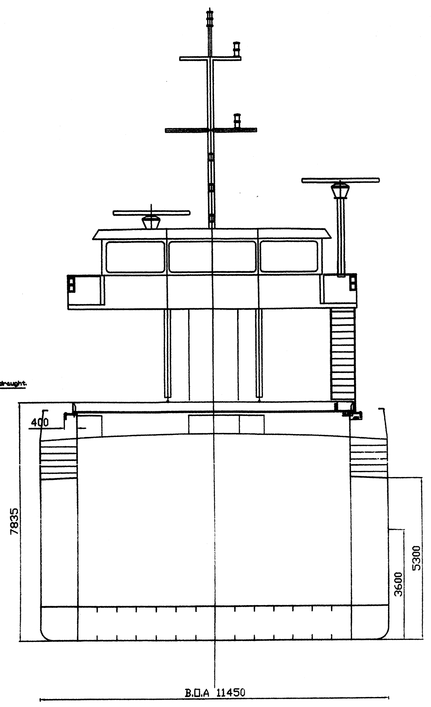

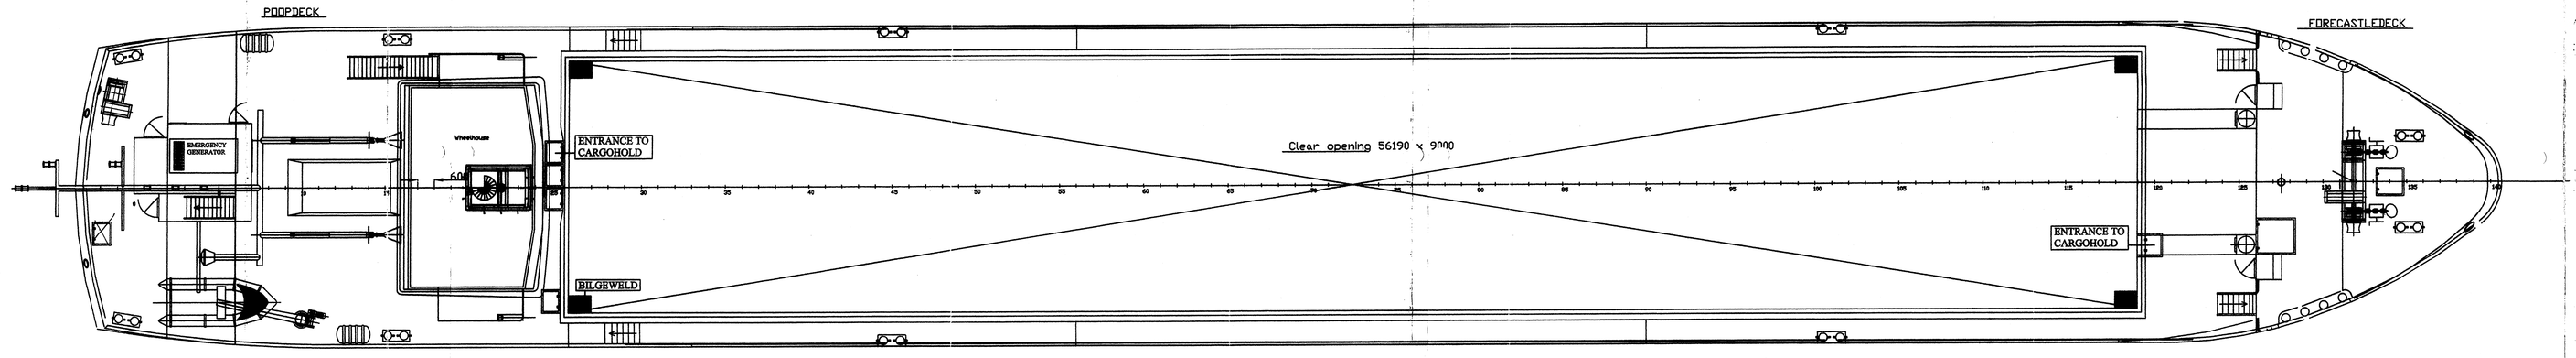

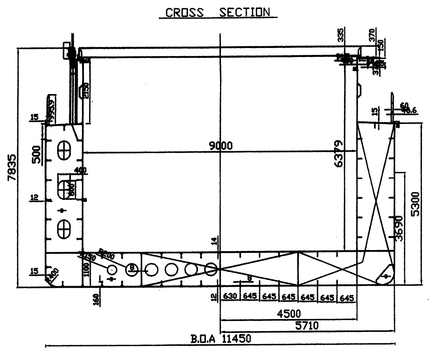

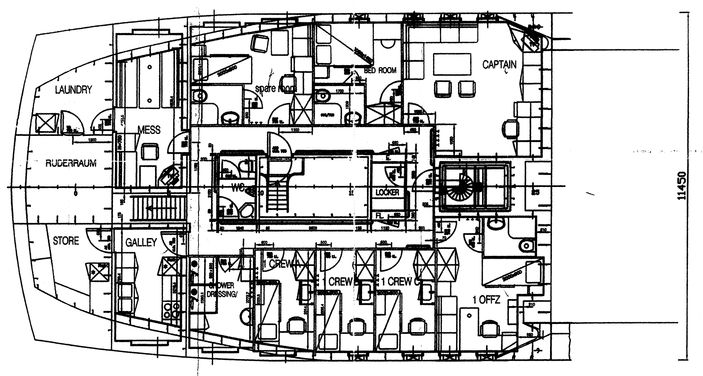

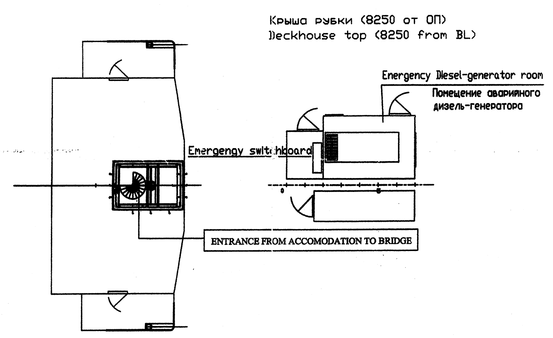

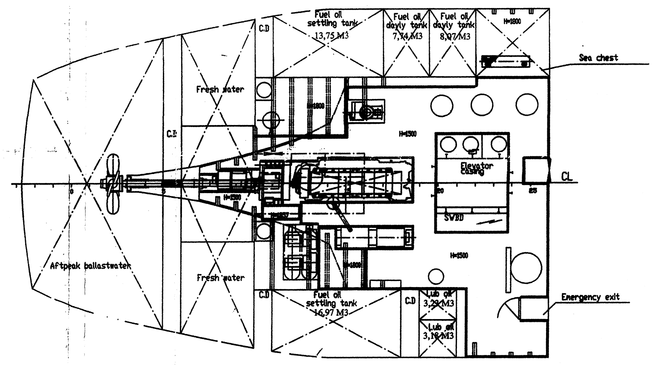

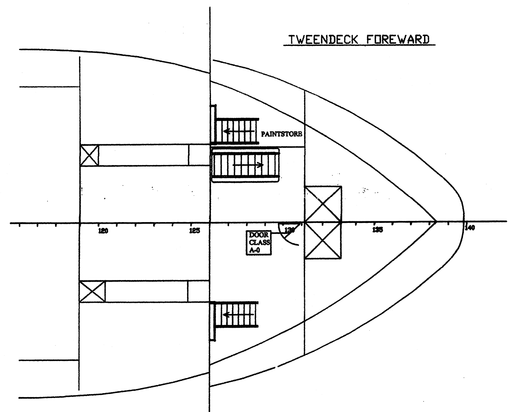

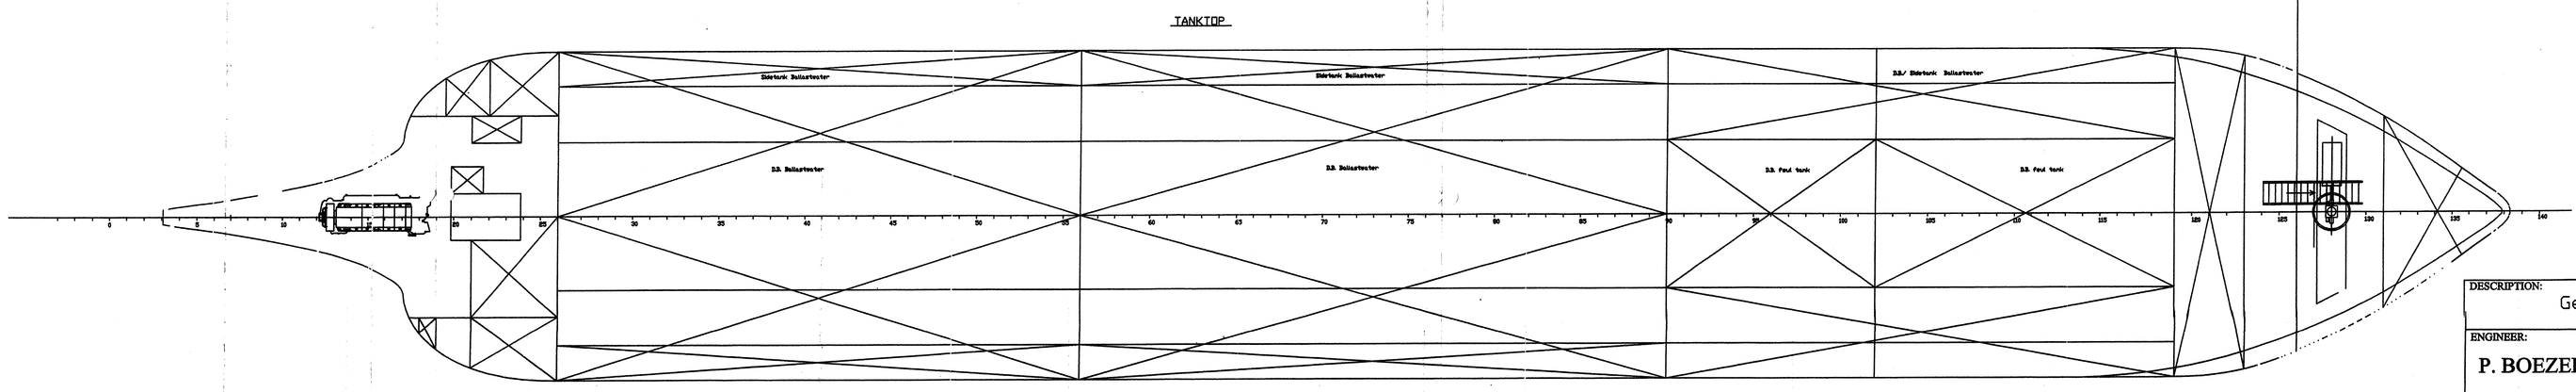

3

3

NETHERLANDS SHIPPING INSPECTORATE
Sailing area: RD
Handled by: ~~ARNHEM~~
Number of remarks: —
APPROVED / ~~NOTED / NOT APPROVED~~
Rotterdam, 20-05-03
Head of Shipping inspectorate (b.o).

To N.S.I. Surveyor's satisfaction

Length over all.		~~82.00~~ mtr
Length betweem perp's		~~83.20~~ mtr
Breadth over all		11.45 mtr
Breadth moulded		11.39 mtr
Depth		5.30mtr
Draught		3.78 mtr
Hold capacity		3200 cbm
Tonnage	approx	2250 DWT
Main engine (medium speed)	approx	750 KW
Speed loaded trail condition	approx	10 Knots
Tankcapacacities: ballastwater	approx	1400 cbm
gasoil bunkers	approx	140 cbm
potable water	approx	25 cbm

DESCRIPTION: General arrangement plan

VESSEL:

ENGINEER: P. BOEZEL

SIZE: A0

SCALE: 1:100

REV.1: 28-12-2000
REV.2: 19-02-2001
REV.3:
DATE:

Adress:
PO-BOX 1100
2980 BC Ridderkerk
Netherlands

Tel.+31 180 419002
Fax.+31 180 411341

email:
drawing@dutch-shipbuilding.com

Copyright of Dutch Shipbuilding Service BV whose property this document remains. No part there of may be disclosed, copied, duplicated or in any other way used without approval of.
Dutch Shipbuilding Service BV.

REMARKS:

DRAWING NO.
KA 90.001.01.A.A