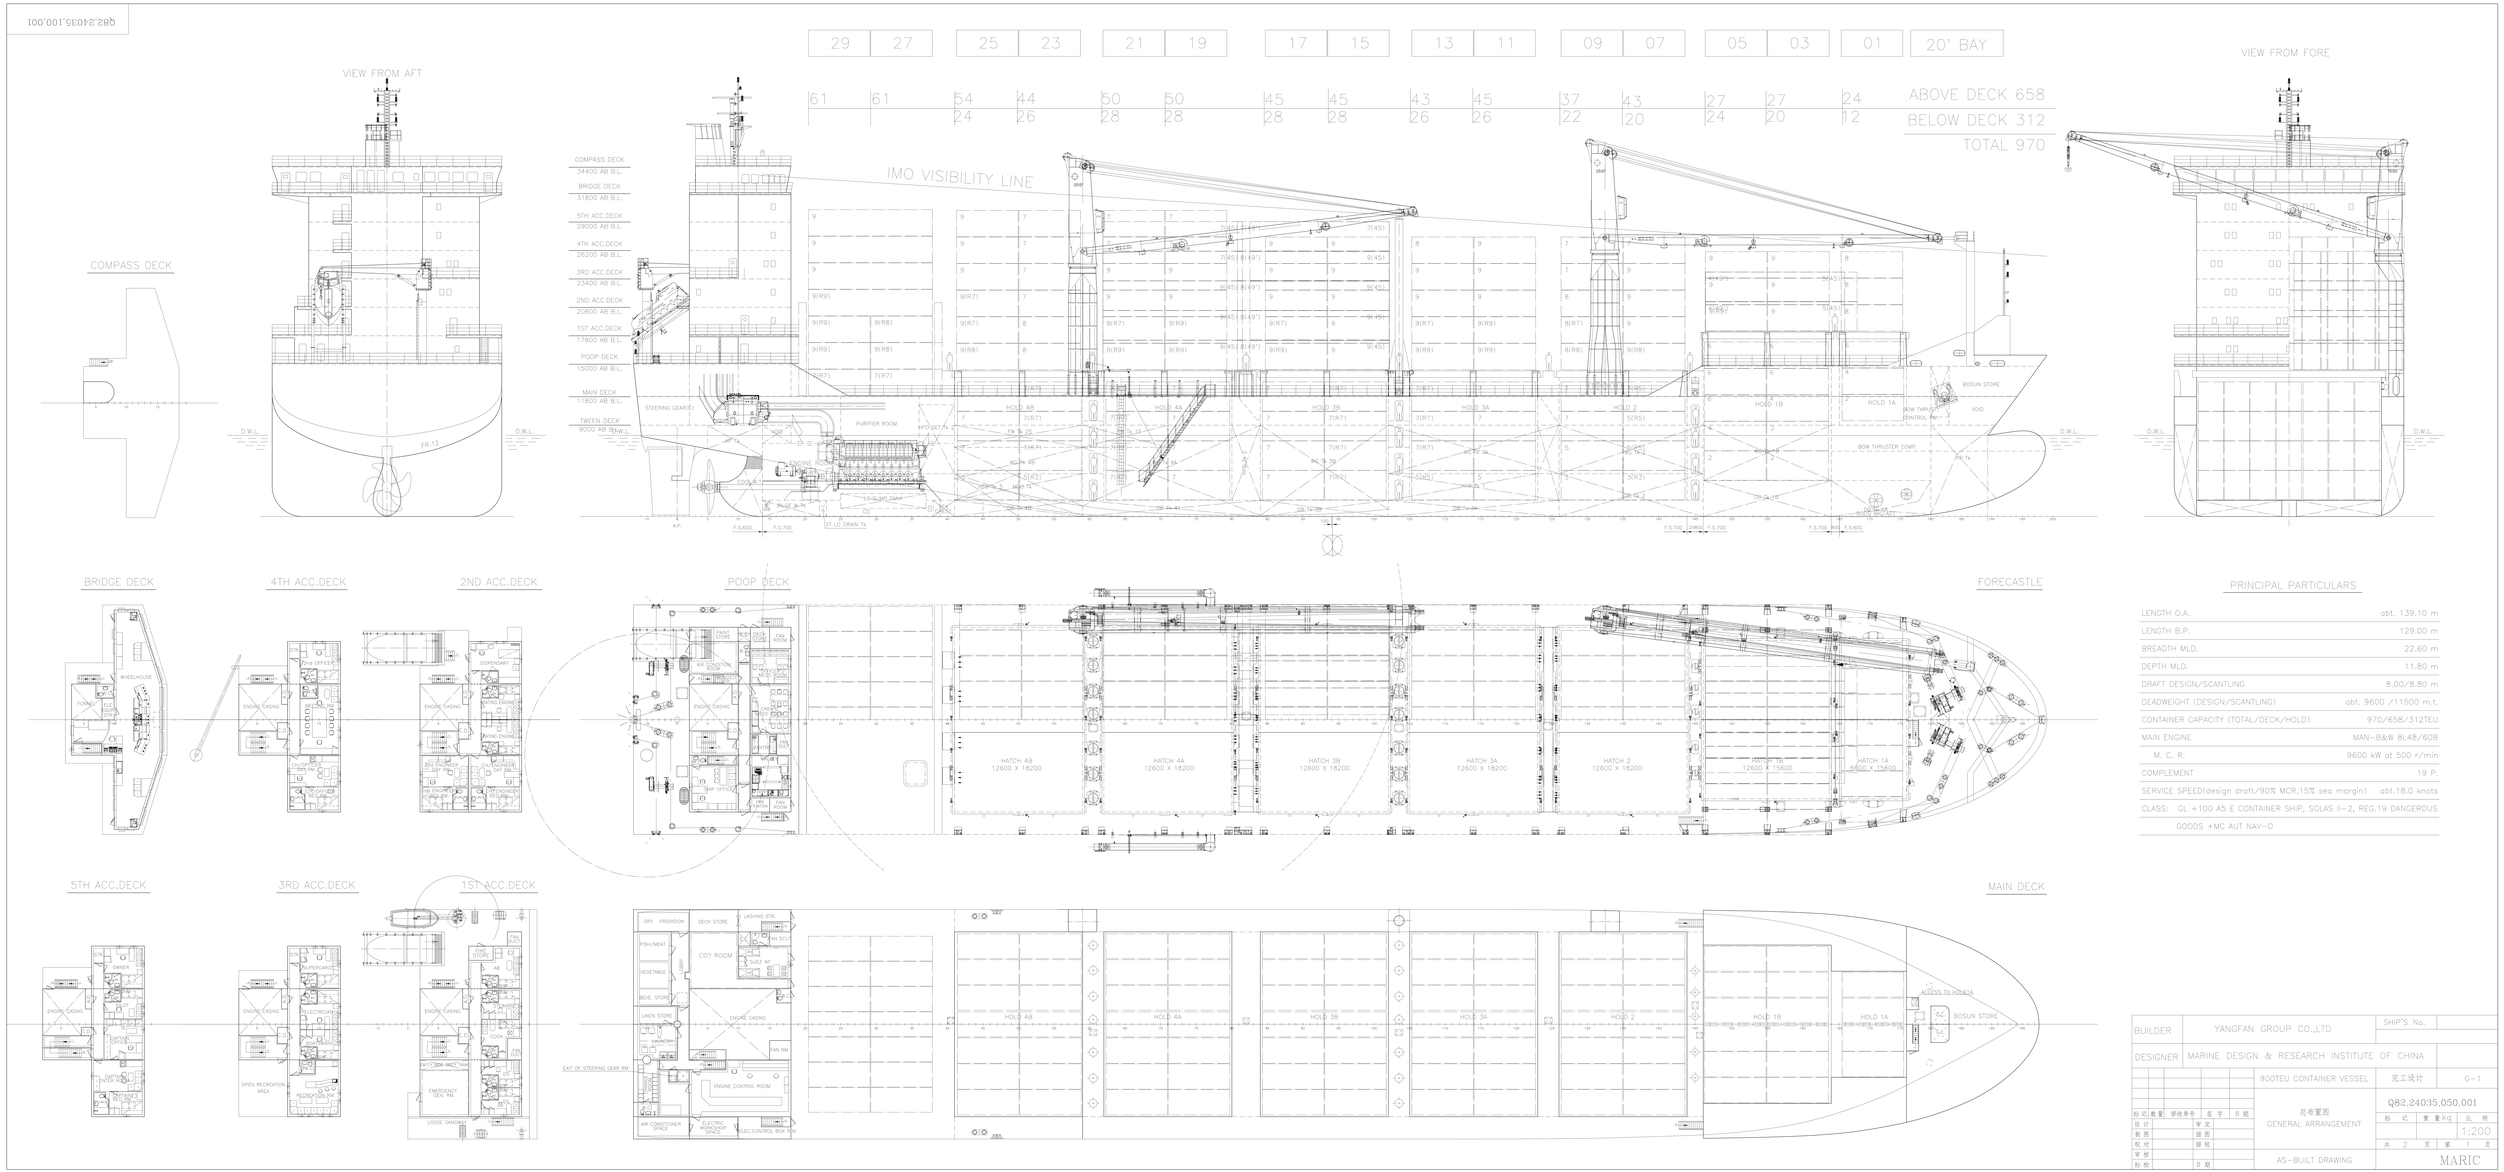

PRINCIPAL PARTICULARS

LENGTH O.A.	abt. 139.10 m
LENGTH B.P.	129.00 m
BREADTH MLD.	22.60 m
DEPTH MLD.	11.80 m
DRAFT DESIGN/SCANTLING	8.00/8.80 m
DEADWEIGHT (DESIGN/SCANTLING)	abt. 9600 /11500 m.t.
CONTAINER CAPACITY (TOTAL/DECK/HOLD)	970/658/312TEU
MAIN ENGINE	MAN-B&W 8L48/60B
M. C. R.	9600 kW at 500 r/min
COMPLEMENT	19 P.
SERVICE SPEED(design draft/90% MCR,15% sea margin)	abt.18.0 knots
CLASS: GL +100 A5 E CONTAINER SHIP, SOLAS II-2, REG.19 DANGEROUS GOODS +MC AUT NAV-0	

BUILDER	YANGFAN GROUP CO.,LTD	SHIP'S No.	
DESIGNER	MARINE DESIGN & RESEARCH INSTITUTE OF CHINA		
	900TEU CONTAINER VESSEL	定工设计	G-1
总布置图 GENERAL ARRANGEMENT		Q82.24035.050.001	
		比例	1:200
		共 2 页 第 1 页	
AS-BUILT DRAWING		MARIC	

设计 审定 制图 描图 校对 描校 审核 标准 日期

标记 数量 修改单号 签字 日期

面积: 0.62m²

Q82.24035.100.001

Q82.24035.100.001

TWEEN DECK

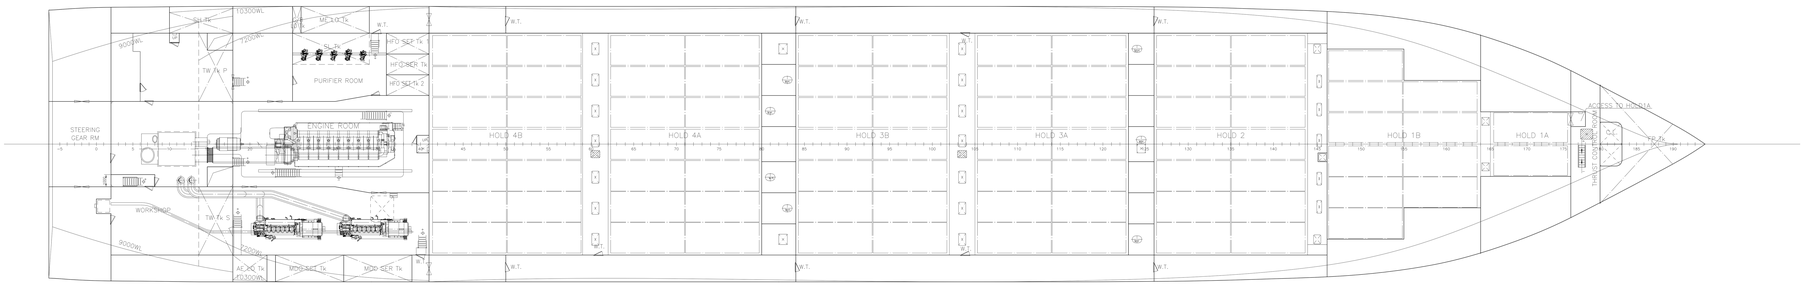

TANK TOP

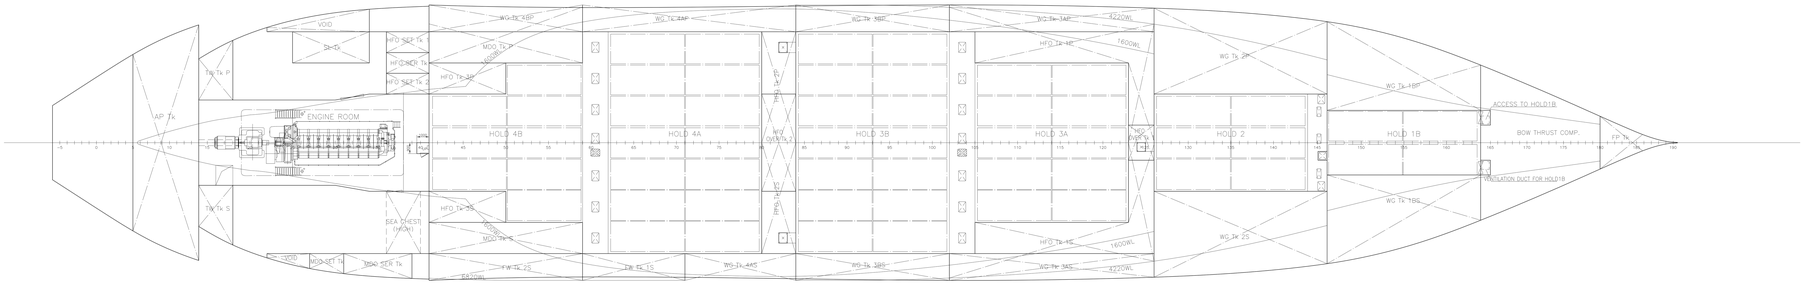

DOUBLE BOTTOM

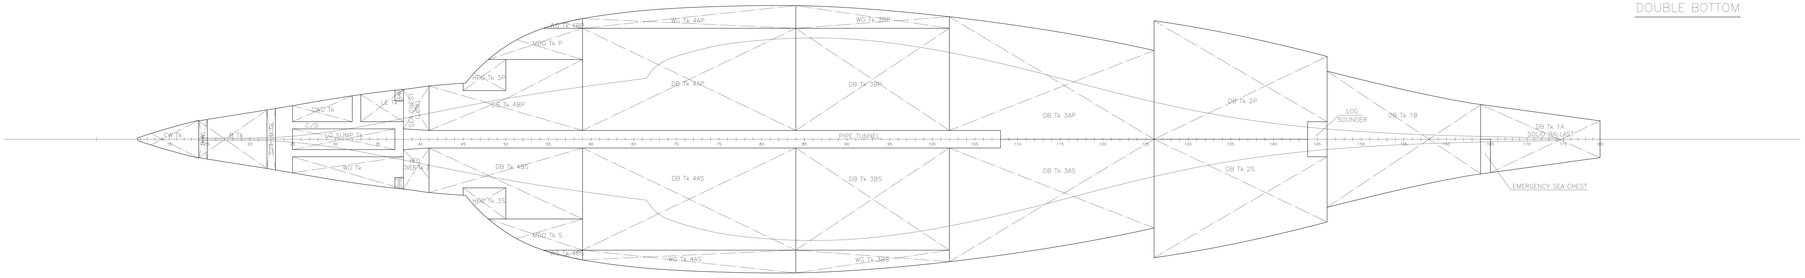

FRAME 60,5 and 103,5
MECHANICAL SUPPLY

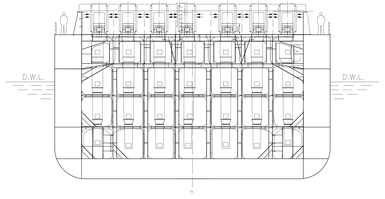

FRAME 80 and 123
NATURAL EXHAUST

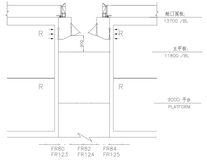

FRAME 144
MECHANICAL SUPPLY

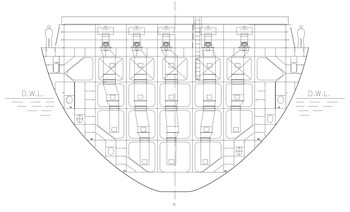

BUILDER	YANGFAN GROUP CO.,LTD	SHIP'S No.	
DESIGNER	MARINE DESIGN & RESEARCH INSTITUTE OF CHINA		
	900TEU CONTAINER VESSEL	定工设计	G-1
标记 数量 修改单号 签字 日期	总布置图 GENERAL ARRANGEMENT	Q82.24035.050.001	
设计 审定		标记 重量kg	比例 1:200
制图 描图			
校对 描校		共 2 页	第 2 页
审核	AS-BUILT DRAWING	MARIC	
标检 日期			

面积: 0.62m²